




Previous Rear (West) Elevation
Scale 1:100

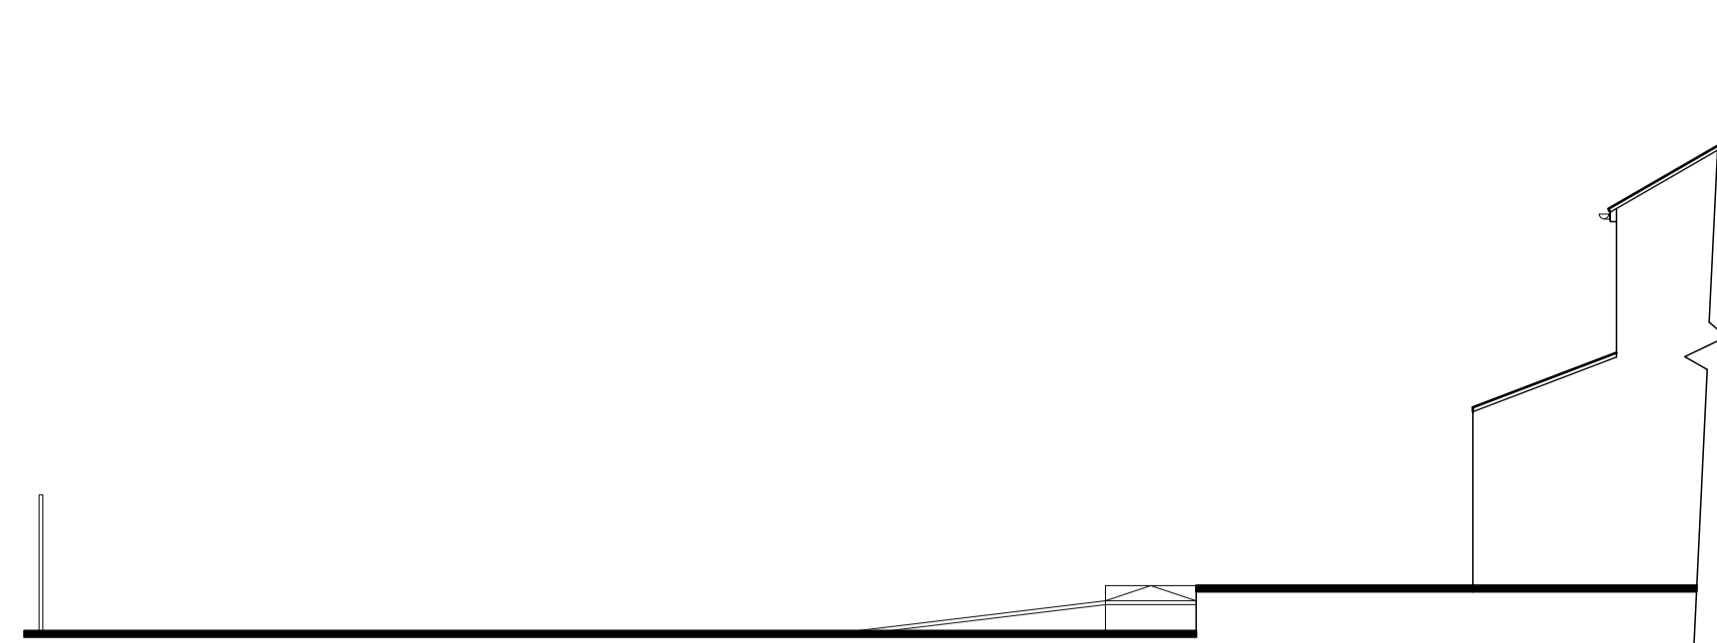

Previous Side (South) Elevation

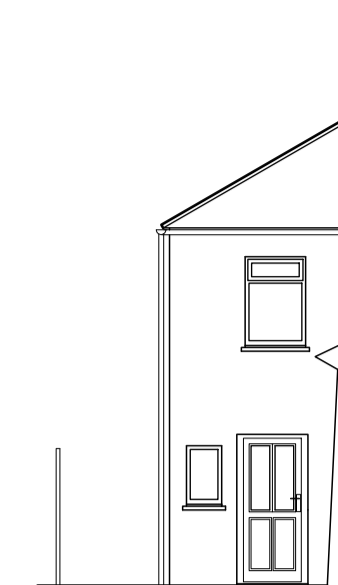


Previous Part Front (East) Elevation

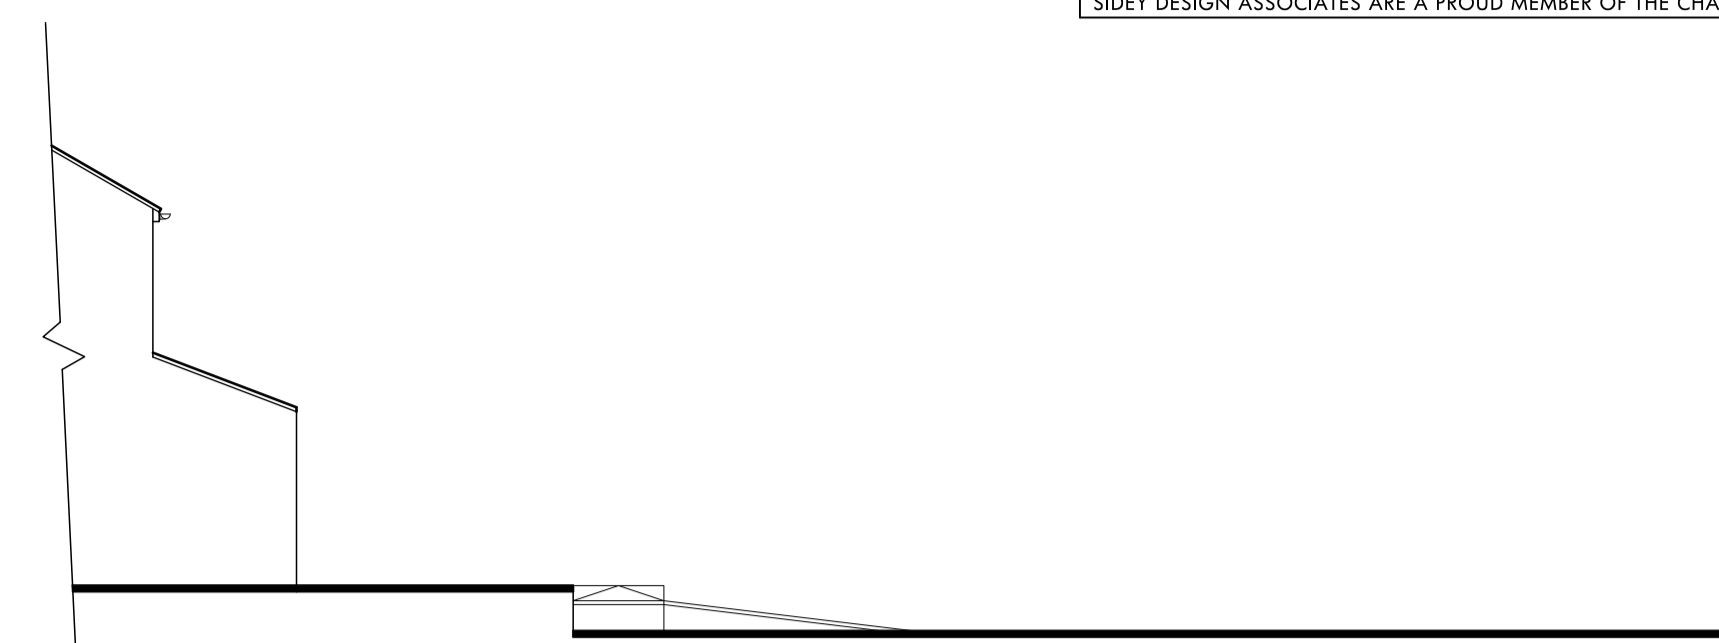

Previous Side (North) Elevation




As Built Rear (West) Elevation
Scale 1:100

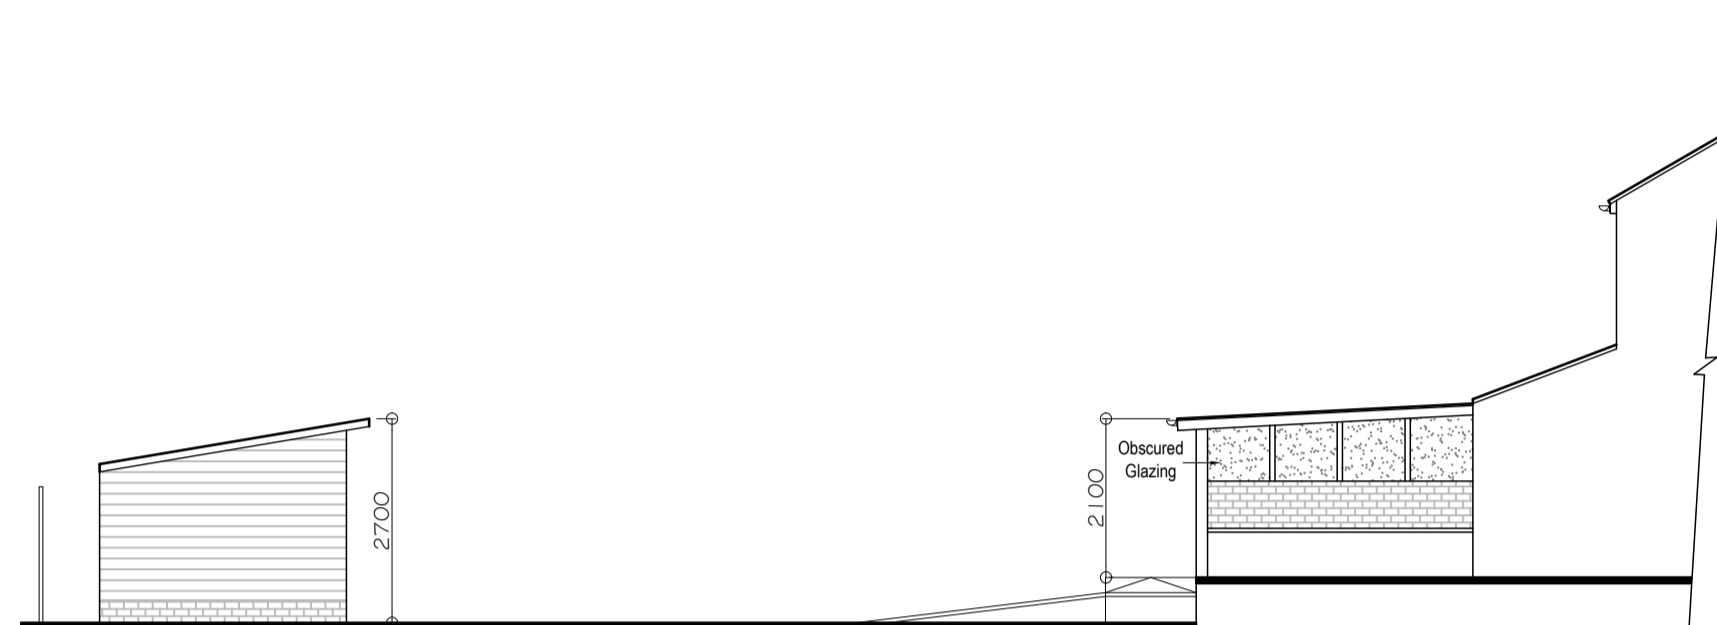

As Built Side (South) Elevation




As Built Part Front (East) Elevation

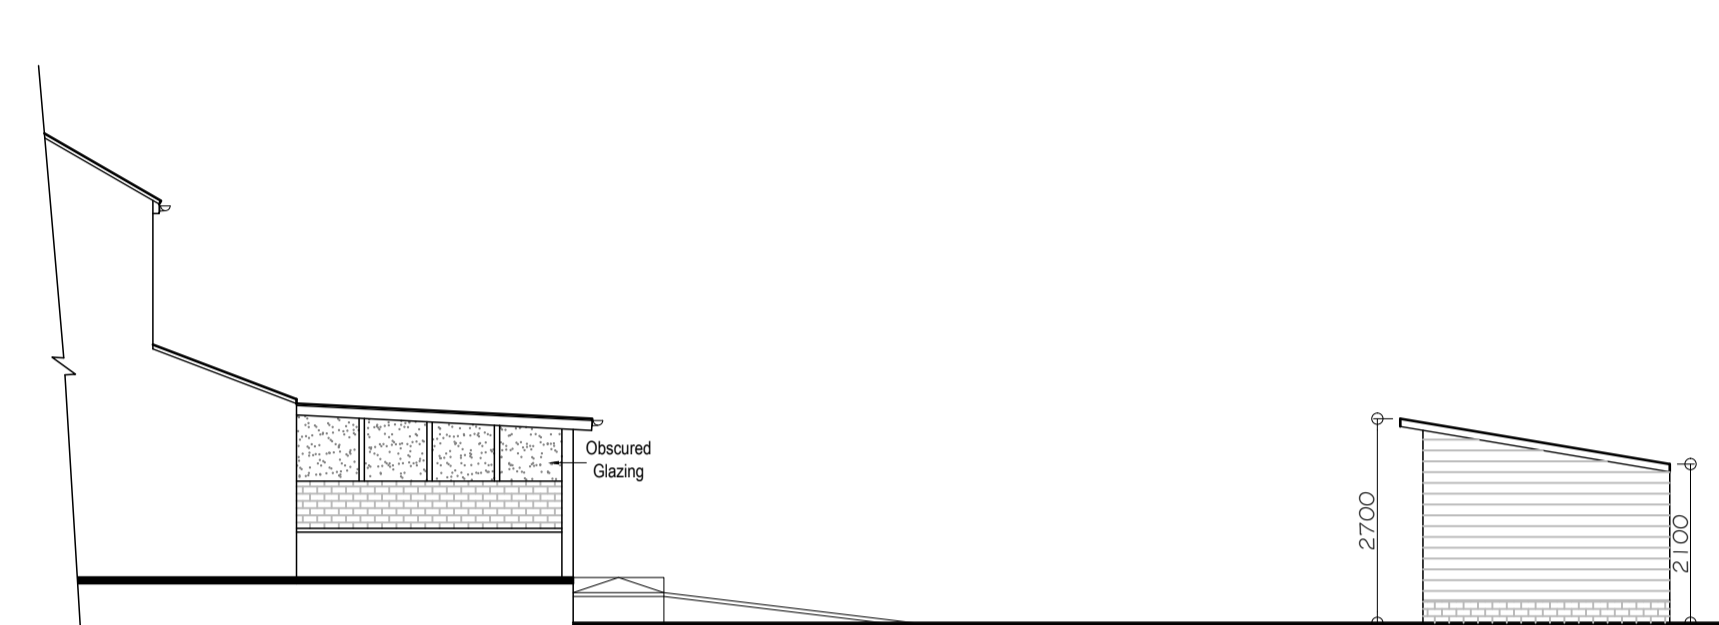


As Built Side (North) Elevation




As Built Garden Room
Front (East) Elevation
Scale 1:100

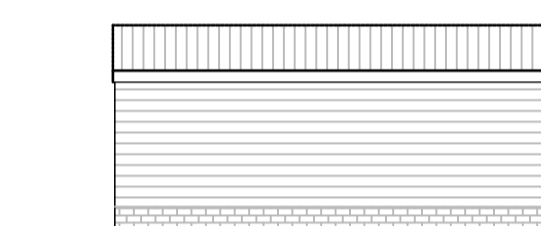

As Built Garden Room
Rear (West) Elevation

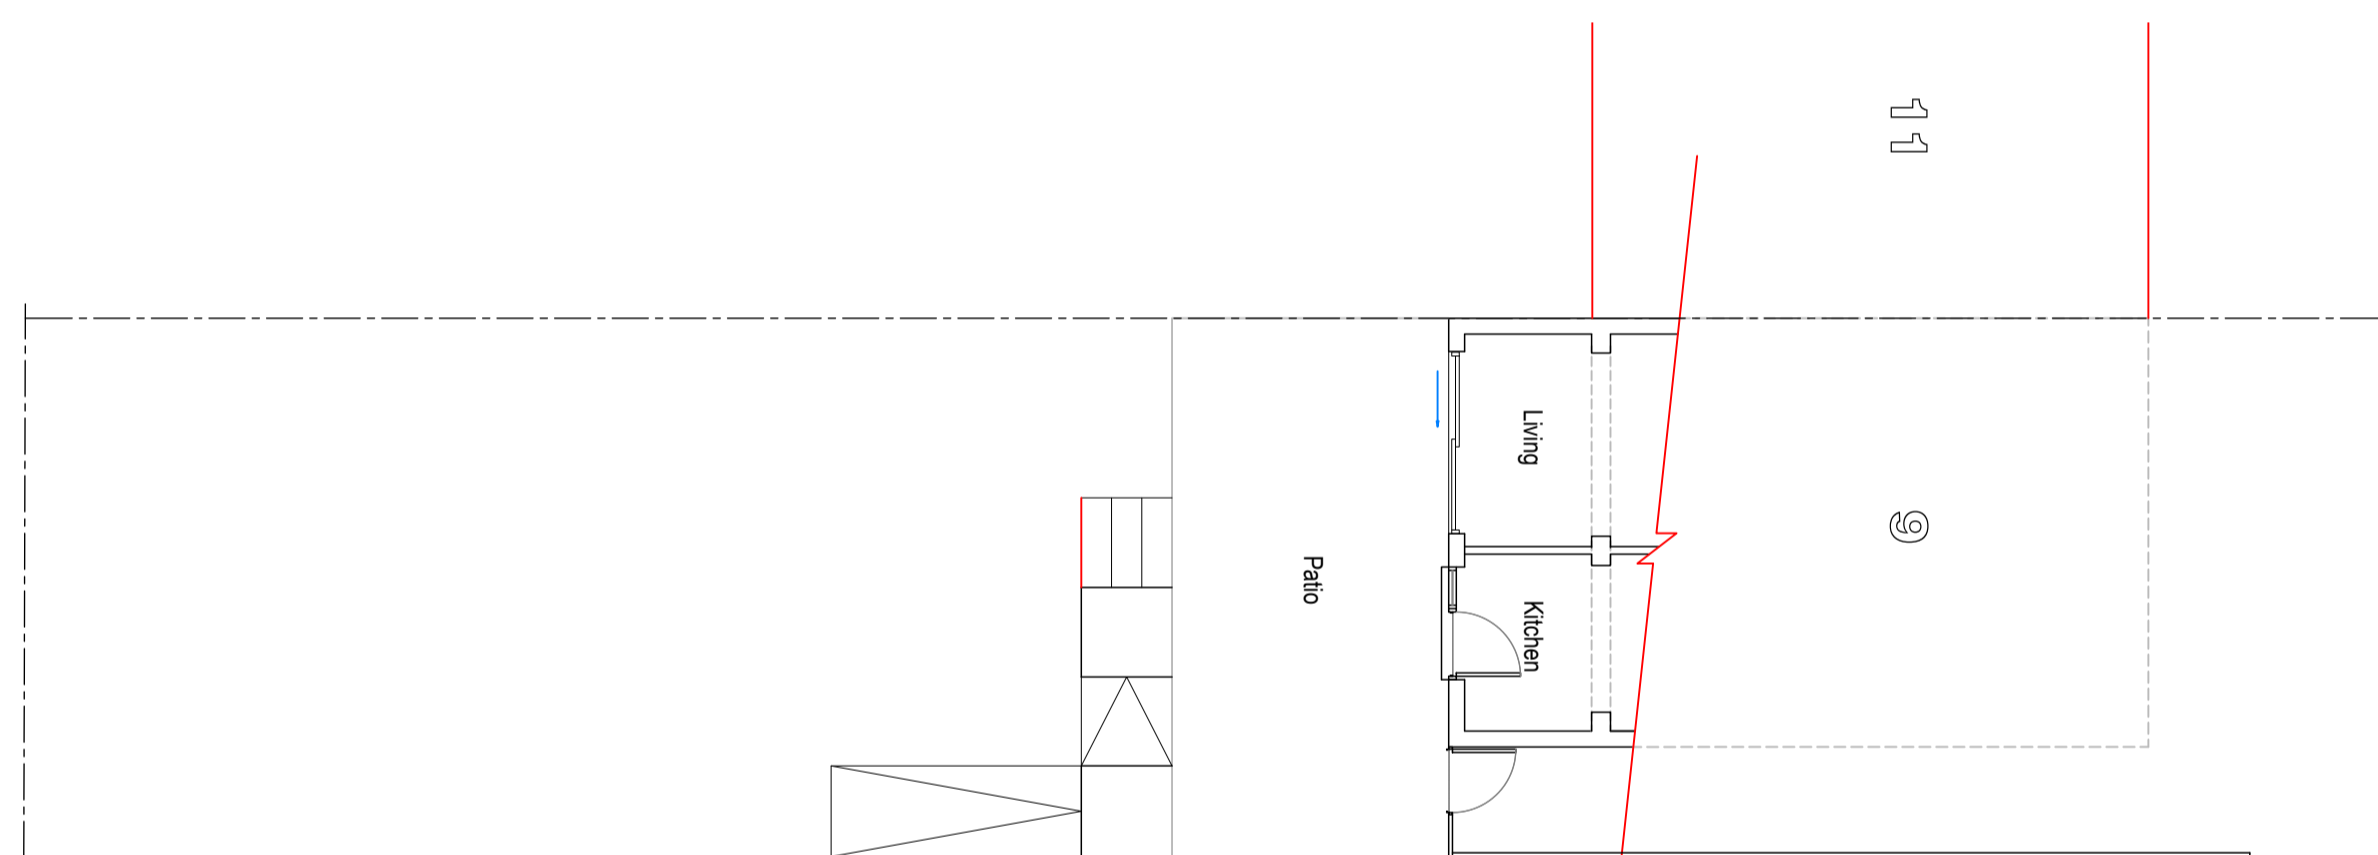

Previous Ground Floor Plan (Prior to development)
Scale 1:100

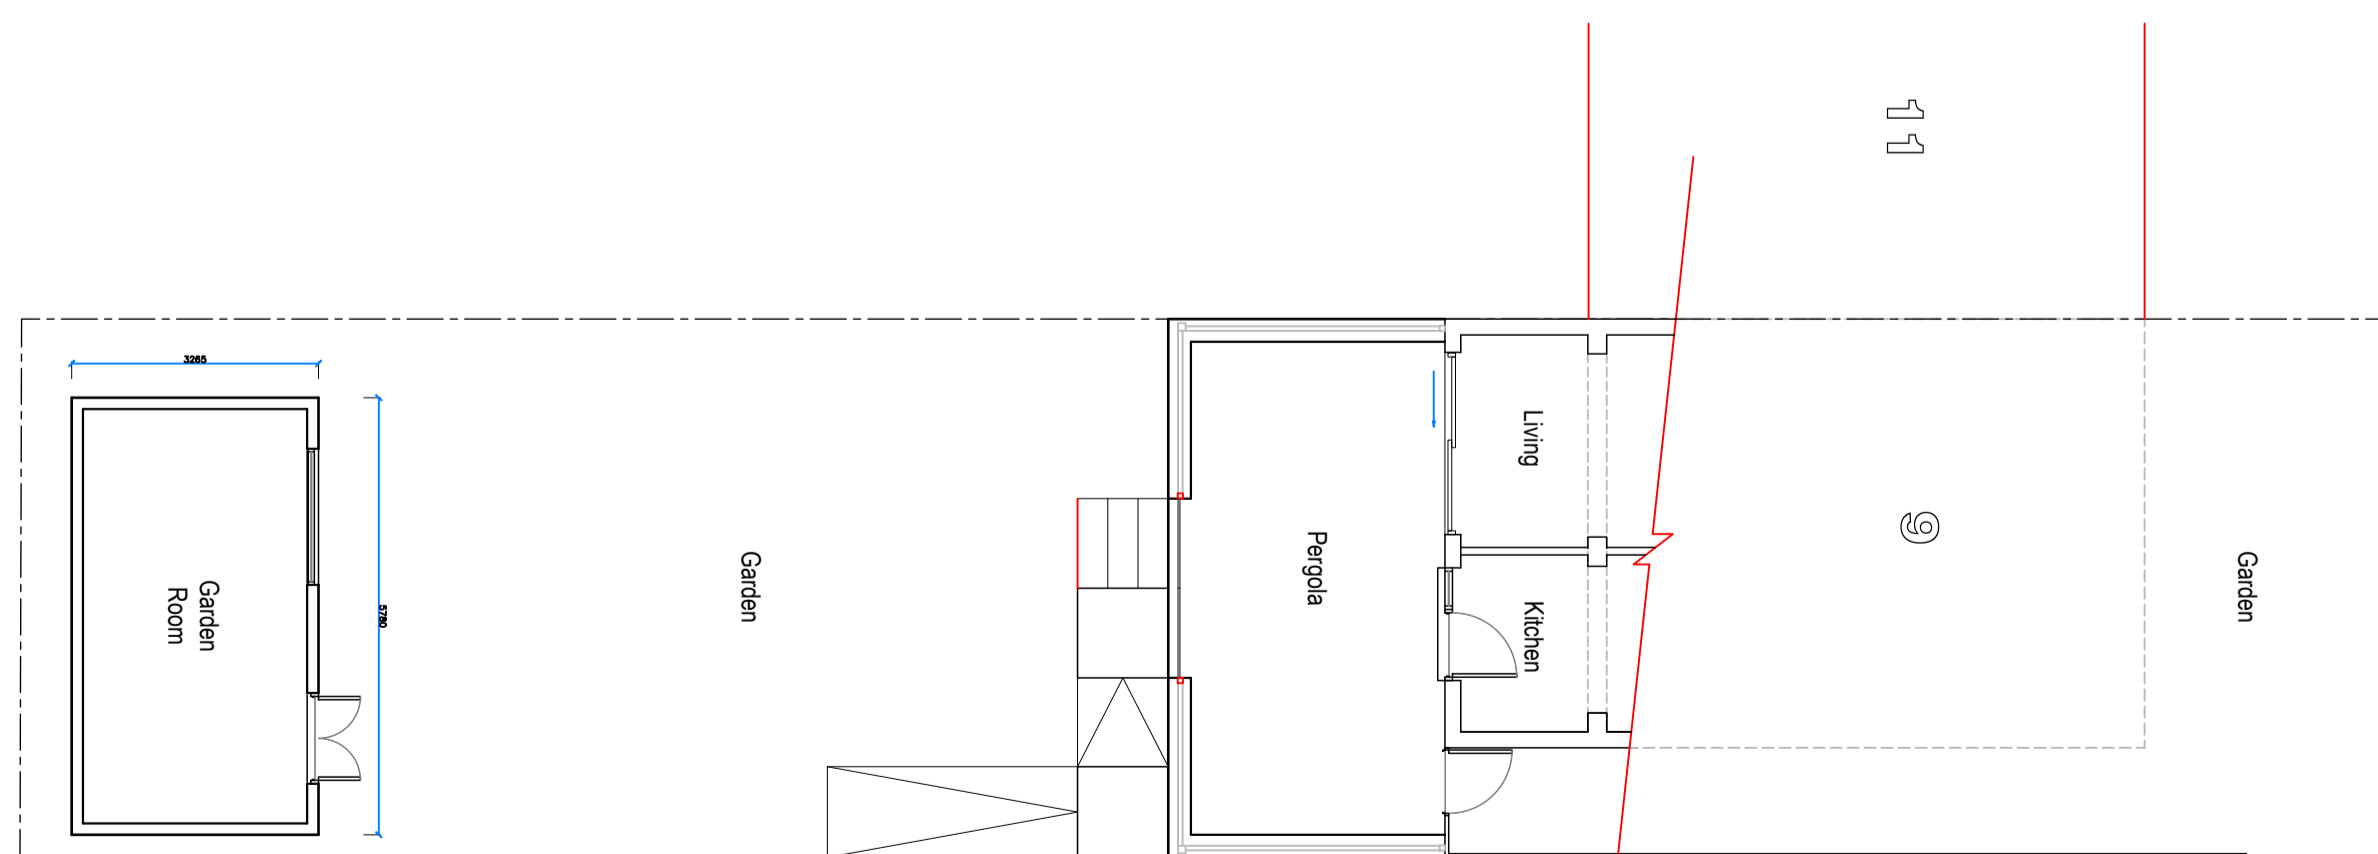

As Built Ground Floor Plan Scale 1:100



Block Plan
Scale 1:1250



Location Plan
Scale 1:1250

Sidey Design
ARCHITECTURE
10 MARKET SQUARE, HIGHAM FERRERS, NN10 8BT
TEL: 01933 317967 FAX: 01933 311161
EMAIL: enquiries@sideydesign.co.uk
WEBSITE: www.sideydesign.co.uk

Client
Mr S Onica

Title
Proposed Rear Extension & Garden Room at
9 George Street, Higham Ferrers,
NN10 8JJ

Drawing
Previous & As Built Plans & Elevations
Location Plan
Block Plan

Drawing Status

PLANNING

Date	Drawn	Checked	Scale	Drawing No.	Rev.
May '22	GS	JMS	As Stated	22-063-01	